



CONCERT HALL AUDIENCE SEATING (CIRCLE) - NOT TO SCALE

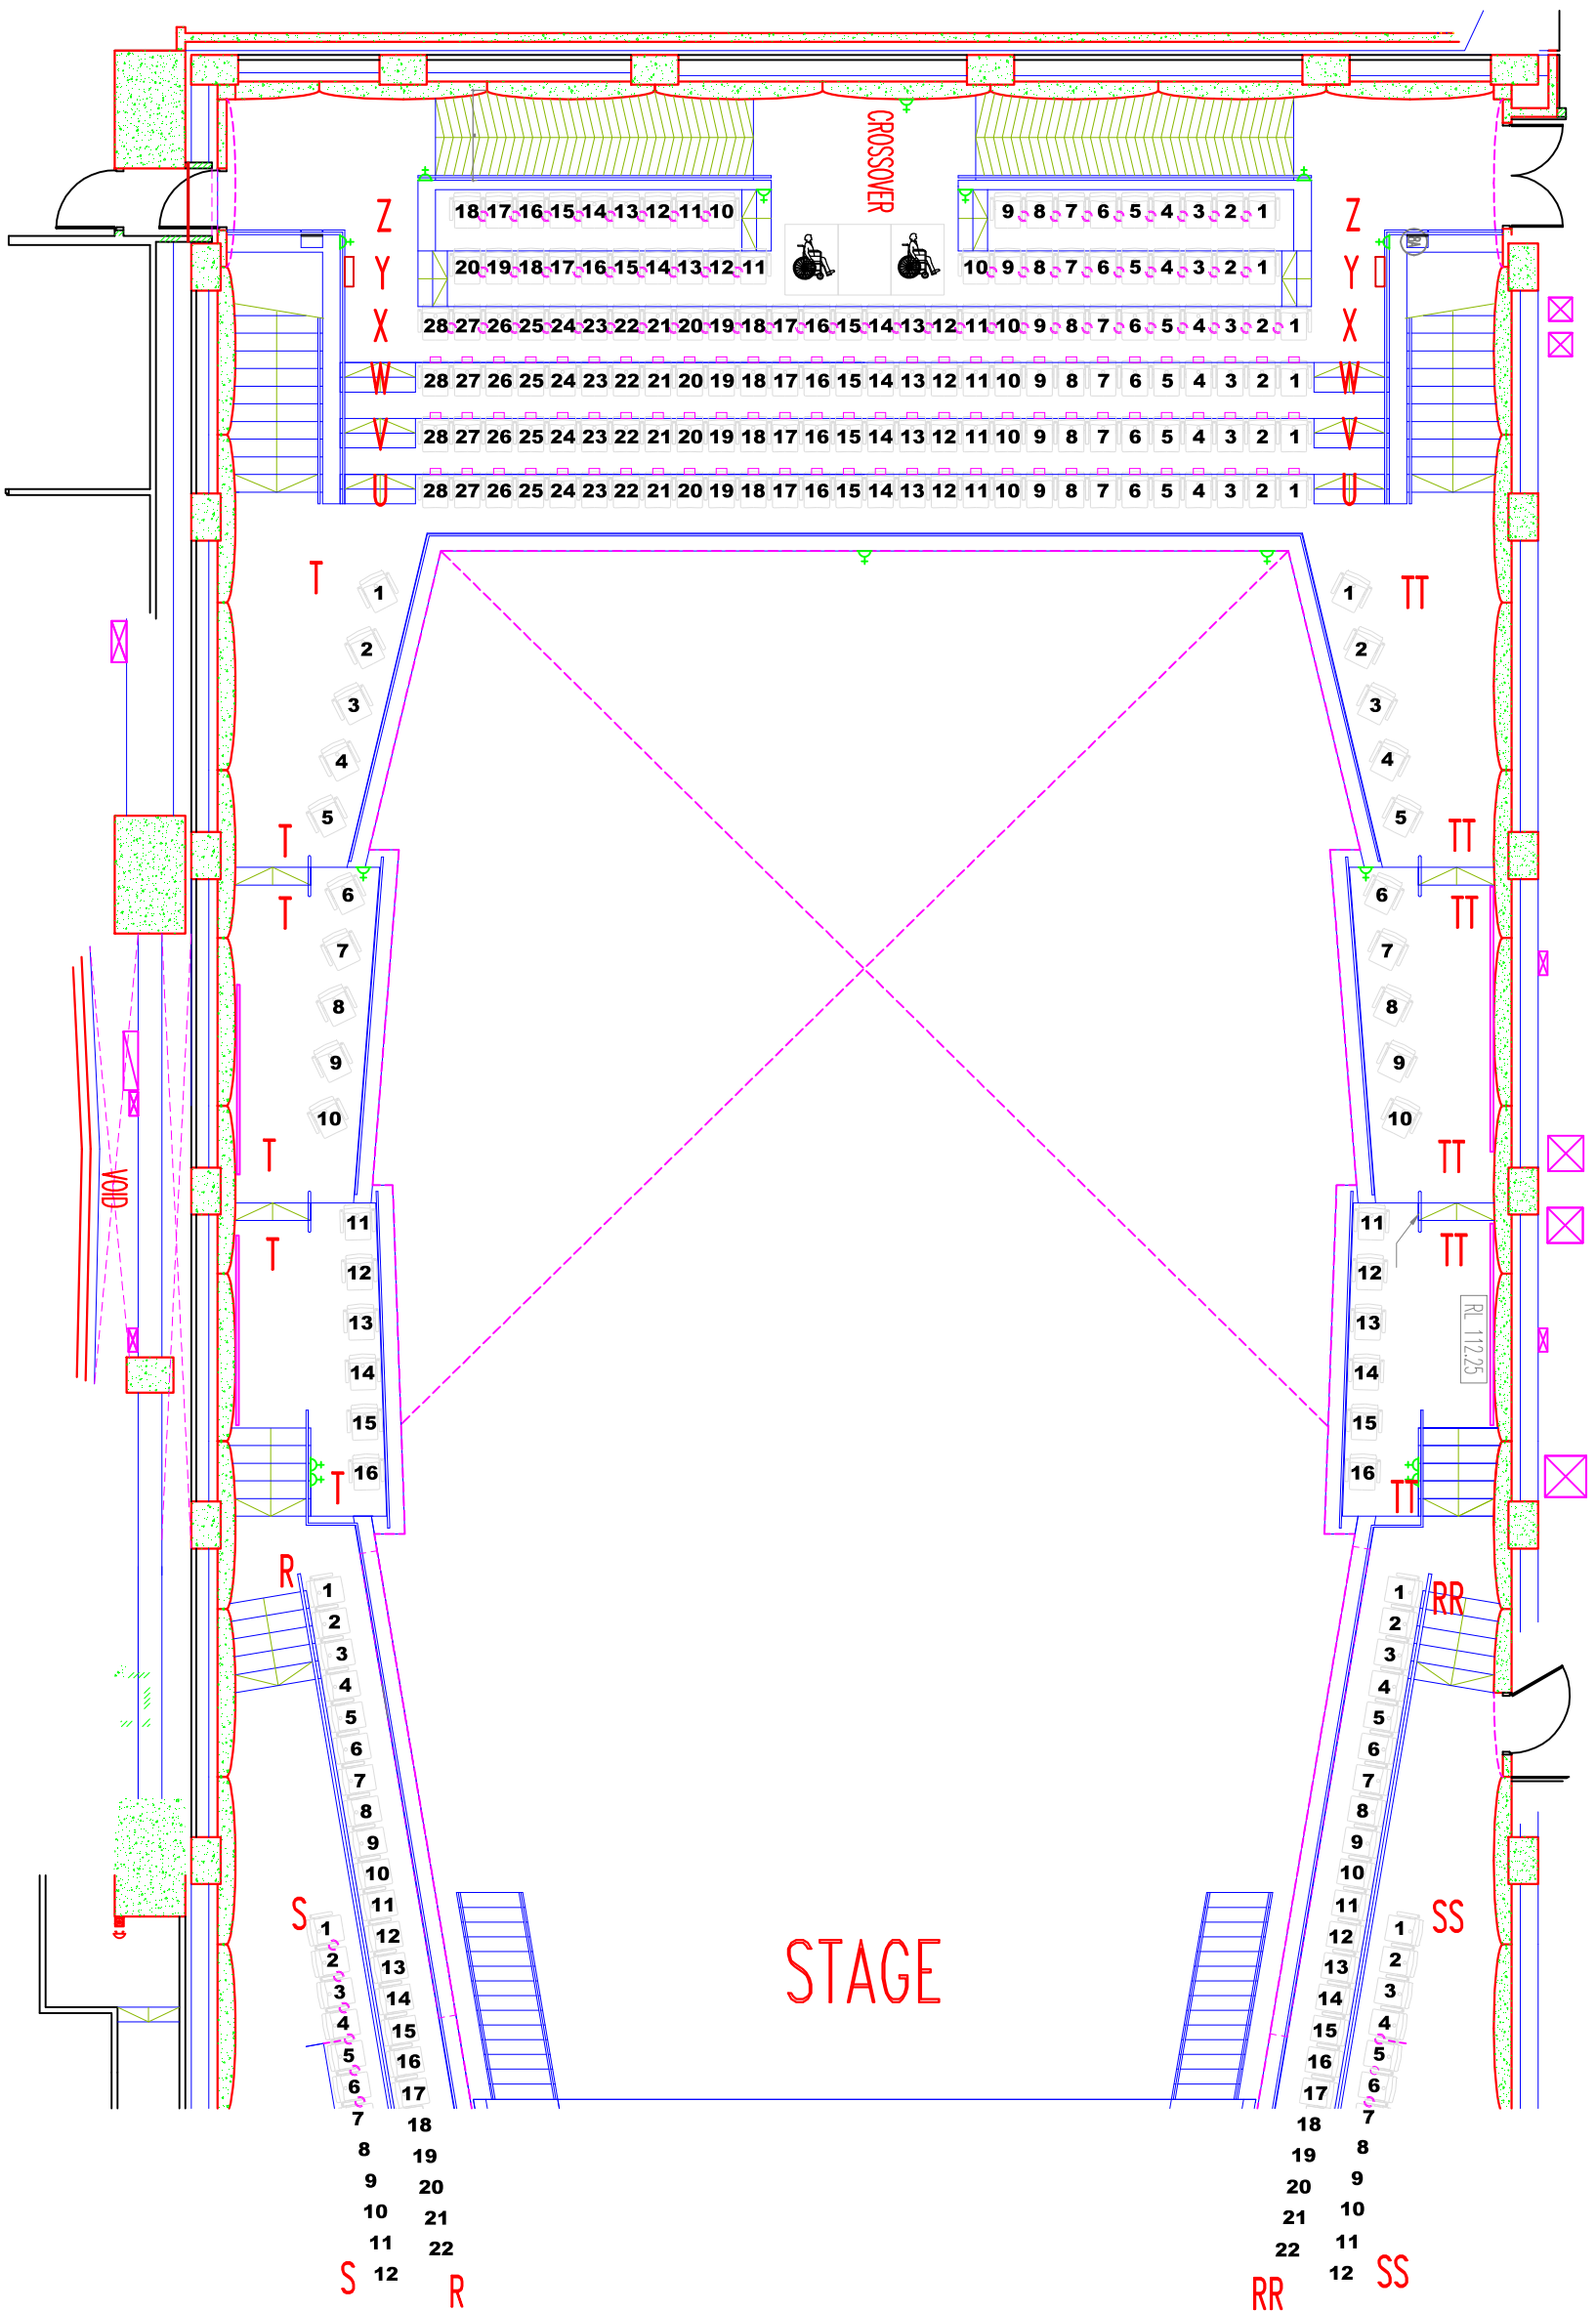

SCHOOL OF THE ARTS SINGAPORE

**MUSIC RECITAL HALL
AUDIENCE SEATING
CIRCLE AREA**

AS-BUILT

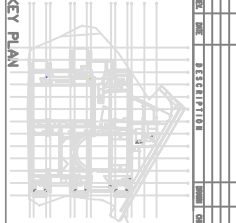

SCHOOL OF THE ARTS SINGAPORE

MUSIC RECITAL HALL
JERZET
AUDIENCE SEATING (CIRCLE AREA)